



COPYRIGHT - THE DESIGN CONNECTION 2002



AREAL PHOTO
SCALE: 1" = 30' (1" = 22' x 34')
SCALE: HALF SCALE (11" x 17")


FILE COPY APPROVED

See comments/requirements in Accela

Permit No. 022-0213RB

Date 6/28/22 Zoning Admin. EJL

LOT 5, BLOCK 1,
SUNSET BAYIDGE
SUBDIVISION

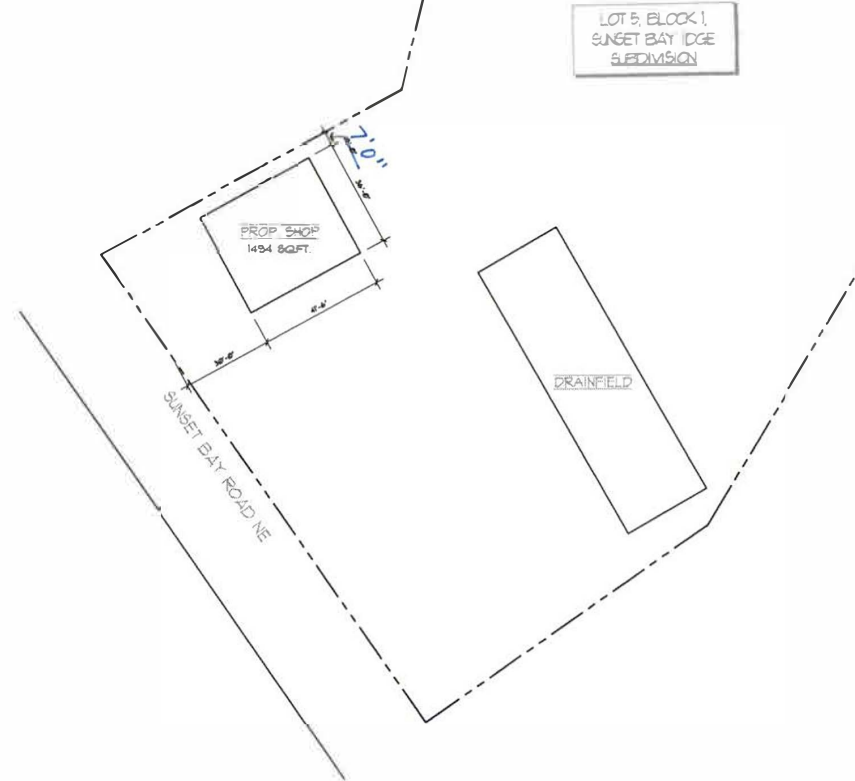

SITE PLAN
SCALE: 1" = 20' (1" = 22' x 34')
SCALE: HALF SCALE (11" x 17")



PEGRAM GARAGE
NICK & NICOLE PEGRAM
ZUMBRO LAKE
PEGRAM & DEXTER CONSTRUCTION
MINNESOTA

PROJECT #	2200
DRAWN BY	BD
CHECKED BY	BD
TOTAL \$1 D118	
DATE	
PRINTED	Jun 01, 2022

SITE PLAN &
RECORD PLAN

C1.0